FIELD MATERIAL

DEVICE TAG	QTY	CODE NUMBER	DESCRIPTION
AF-1	1	A-4000-141	FILTER STATION; REDUCING
TS-1-TS-2	16	T26A-14C	LINE VOLTAGE THERMOSTAT

UNIT HEATERS

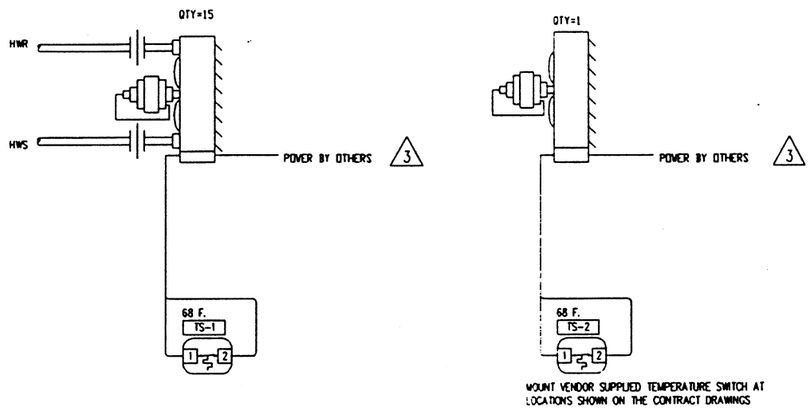

PNEUMATIC POWER

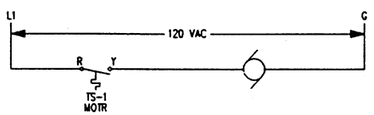

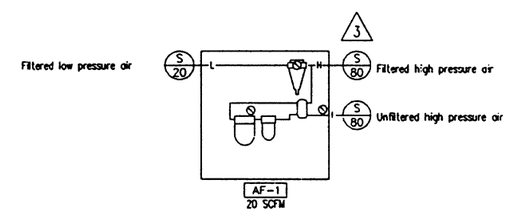

HOT WATER UNIT HEATERS

WALL MOUNTED TEMPERATURE SWITCH, TS-1 WILL CYCLE UNIT HEATER FAN TO MAINTAIN A SPACE TEMPERATURE SETPOINT OF 68 F.(ADJUSTABLE)

ELECTRIC UNIT HEATERS

WALL MOUNTED TEMPERATURE SWITCH WILL CYCLE UNIT HEATER CONTROLS TO MAINTAIN THE CONTROL SETPOINT.

COPYRIGHT JOHNSON CONTROLS, INC.1993

FILE: UH-411
DCODE: 19930628.1624

REFERENCE DRAWING	NO.	REVISION-LOCATION	ECN	DATE	BY
		AS BUILTS		06/28/93	DCS
	2	GENERAL		04/27/92	SF
	1	GENERAL		04/23/92	SF

DRAWING TITLE
Building 411
Unit Heaters

Pneumatic Power Supply

SALES ENGR	PROJECT MGR	APPL. ENGR	DRAWN	APPROVED
JP	SF	DCS	BY SF DATE 01/15/92	BY DATE

PROJECT
The Argonne National Labs
Advanced Photon Source Campus
9700 Cass Avenue South
Argonne, IL 60439

JOHNSON CONTROLS
Systems & Services Division

3007 MALMO ROAD
ARLINGTON HEIGHTS
ILLINOIS 60005
708/364-1500 Main
708/806-4438 Eng

CONTRACT NUMBER
91390-0009

DRAWING NUMBER
91-9-B-08A