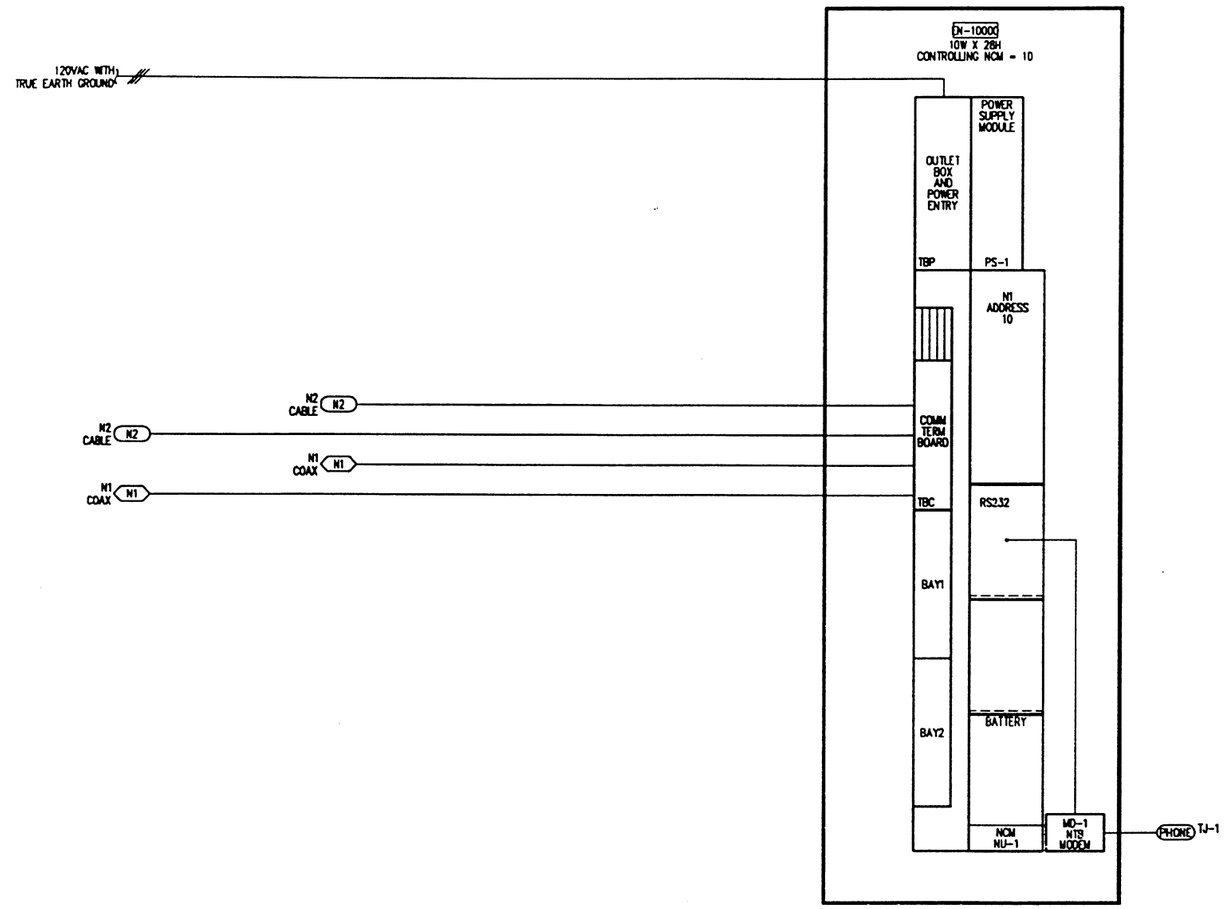

PANEL MATERIAL

	DEVICE TAG	QTY	CODE NUMBER	DESCRIPTION
(P)	EN-10000	1	EN-BSF121-0	1 SLOT BASE FRAME
		1	EN-CVC101-0	
		1	EN-ENC101-0	
(P)	MO-1	1	OPTIMA 144	MODEM-HAYES
(P)	NU-1	1	NU-NCR200-0	NETWORK CONTROL MODULE
		1	NU-COM101-0	RS232 SUBMODULE
		1	NU-MIN102-0	NETWORK IDENTITY MODULE;
(P)	PS-1	1	NU-PWR101-0	POWER SUPPLY

Enclosure, EN-10000, NCU Serving HVAC ASCs & ICS Alarms

COPYRIGHT JOHNSON CONTROLS, INC.1993

DRAWING TITLE
Enclosure, EN-10000
Network Control Unit, NCU
Serving HVAC ASCs

REFERENCE DRAWING	NO.	REVISION-LOCATION	ECN	DATE	BY
		AS BUILTS		06/28/93	DCS
	1	CHANGE ADDRESS		11/10/92	SF

SALES ENGR	PROJECT MGR	APPL. ENGR	DRAWN	APPROVED
JP	SF	DCS	BY SF DATE 11/11/91	BY DATE

FILE:
DCODE:

PROJECT
The Argonne National Labs
Advanced Photon Source Campus
9700 Cass Avenue South
Argonne, IL 60439

JOHNSON CONTROLS
Systems & Services Division

3007 MALMO ROAD
ARLINGTON HEIGHTS
ILLINOIS 60005
708/364-1500 Main
708/806-4438 Eng

CONTRACT NUMBER
91390-0009

DRAWING NUMBER
91-9-B-11A